

DRAWING NUMBER

DRAWING NUMBER

DRAWING NUMBER

A-104
Cantor F.
AA-07

METROPOLITAN FIBER SYSTEMS OF NEW YORK AT THE WORLD TRADE CENTER

TENANT

THE CANTOR FITZGERALD SECURITIES COMPANY

LOCATION

ONE WORLD TRADE CENTER - 104th FLOOR

SHEET NUMBERS


AA
T1
T2

DRAWING NUMBERS


07-012--TYP-A-00A
07-012-1WT-P2-54-T1
07-012-1WT-P2-54-T2

DESCRIPTION


MFS-NT MASTER NOTES
80th FLOOR - PROPOSED CABLE ROUTES
104th FLOOR- PROPOSED CABLE ROUTES

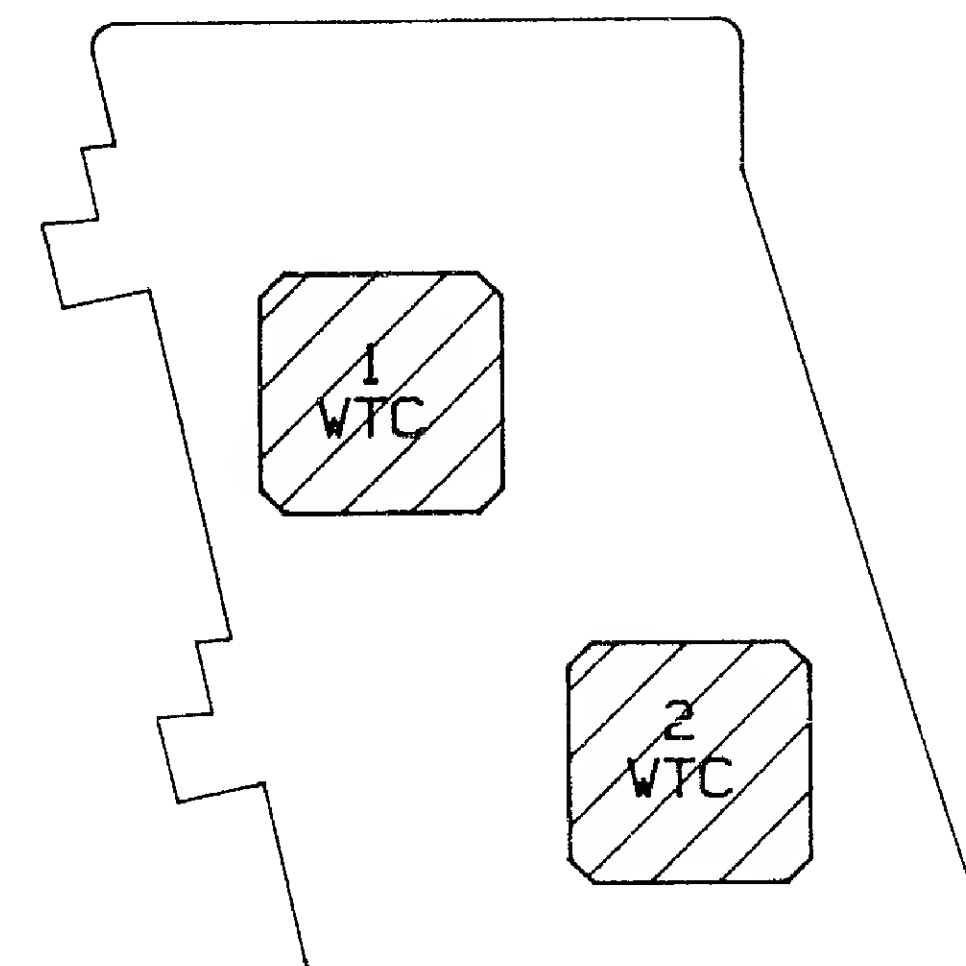

KEY PLAN
NTS

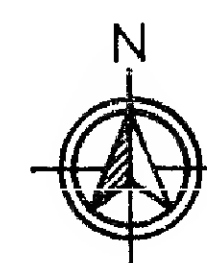

AS-BUILT

 KIEVIT NETWORK TECHNOLOGIES. I					
PROJECT METROPOLITAN FIBER SYSTEMS OF NEW YORK				INFORMATION ON PROPRIETARY AND USED, COPIED, R DISCLOSED IN WR WITHOUT WRITTEN	
TITLE WORLD TRADE CENTER PHASE 2				SCALE	NOT TO
				SIZE	
ORIGIN	DATE	DRAWN	DATE	APPROVED	DATE
AL A	8/24/92	AL A	8/24/92	AL A	8/24/92